




LOCATION PLAN

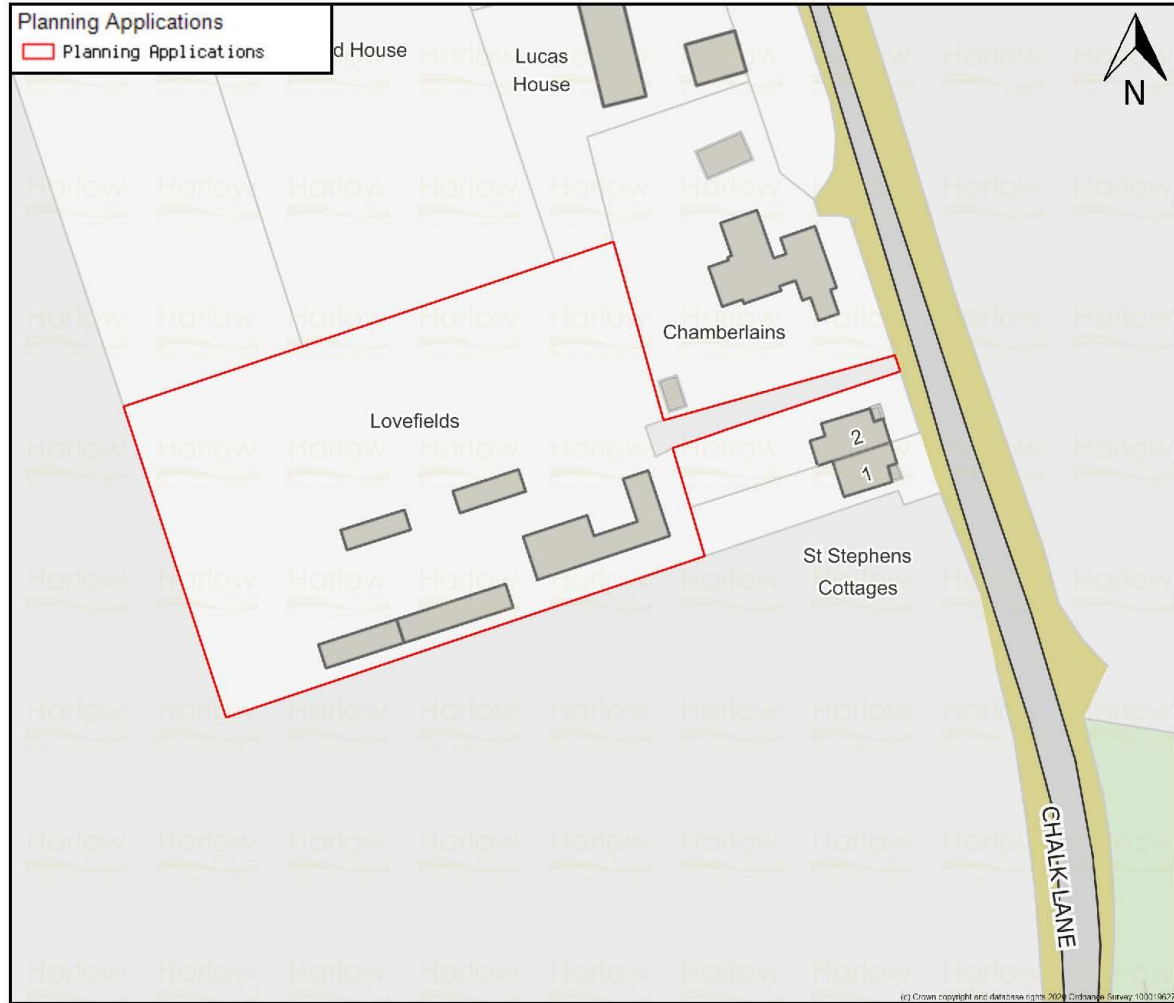


AS BUILT GROUND FLOOR PLAN

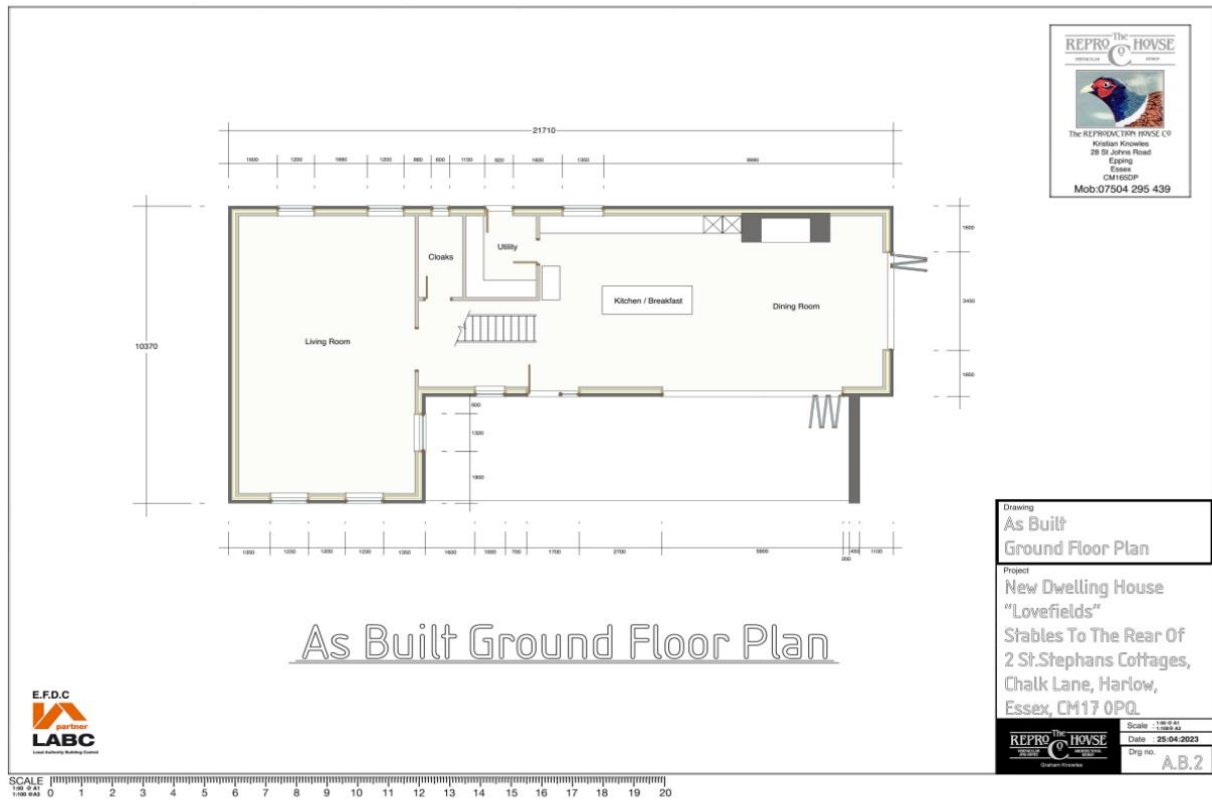


AS BUILT FIRST FLOOR PLAN

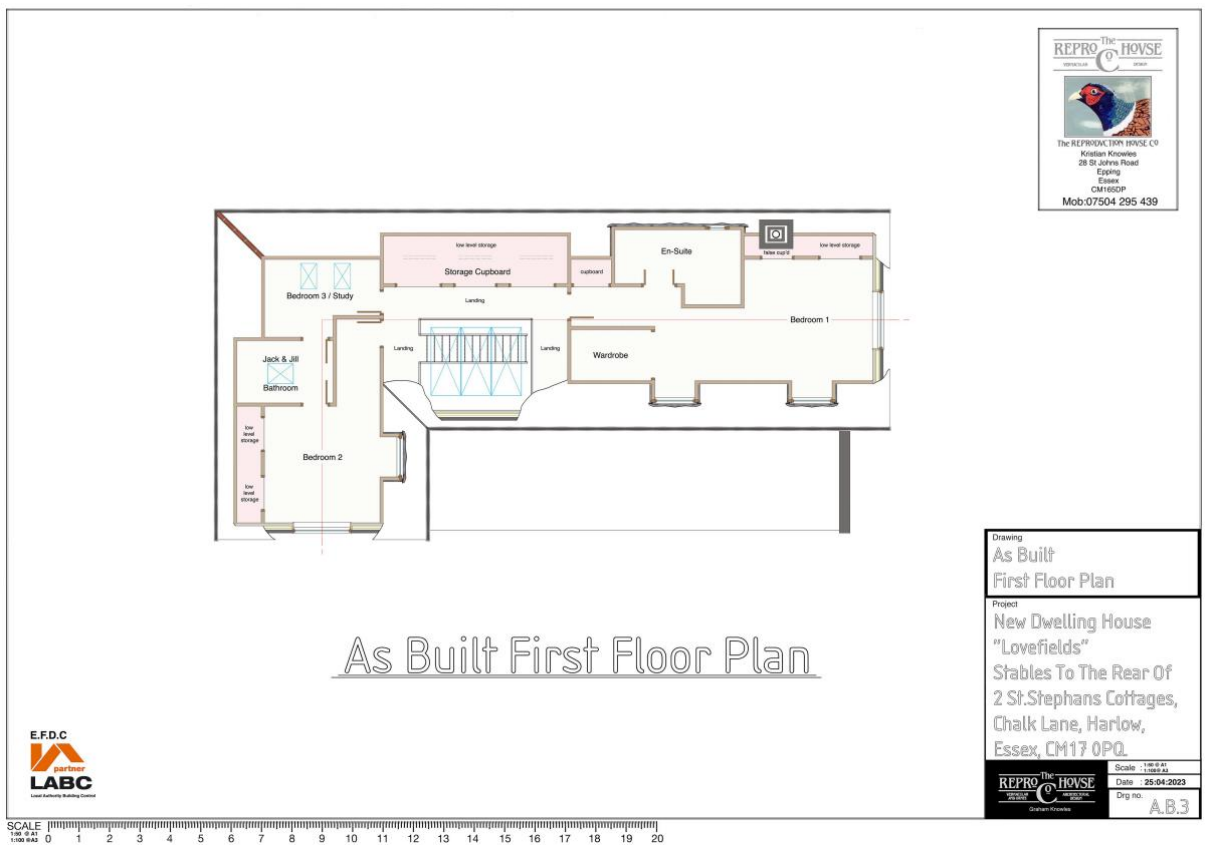

AS BUILT ROOF PLAN

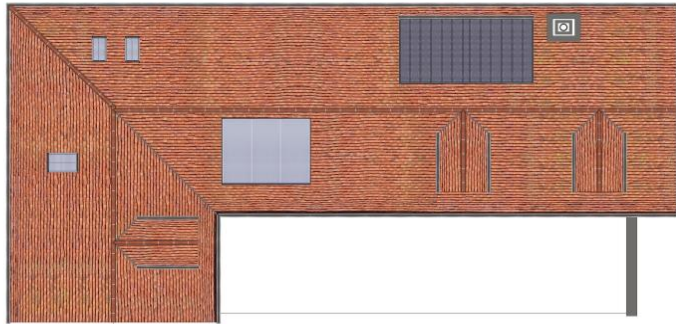

REPRO The HOUSE
REPRODUCTION HOUSE CO



The REPRODUCTION HOUSE CO
 Kristian Knowles
 28 St Johns Road
 Epping
 Essex
 CM165DP
 Mob:07504 295 439

As Built Roof Plan

E.F.D.C
ESSEX COUNTY COUNCIL
LABC
Local Authority Building Control

Drawing
**As Built
 Roof Plan**

Project
**New Dwelling House
 "Lovefields"
 Stables To The Rear Of
 2 St. Stephans Cottages,
 Chalk Lane, Harlow,
 Essex, CM17 0PQ.**

Scale	1:100 (A1)
Date	25-04-2023
Dwg no.	A.B.4

SCALE 1:100 (A1) 1:100 (A1) 0 1 2 3 4 5 6 7 8 9 10 11 12 13 14 15 16 17 18 19 20

AS BUILT ELEVATIONS



Side Elevation

Front Elevation

Rear Elevation

Side Elevation

MATERIALS:-
 ROOF- Hand made plain clay tiles as agreed with HB & CA min pitch 37.5-45 degree
 WALLS- Antique multi red facing brick to match local vernacular
 WINDOWS / DOORS- Double glazed black / anthracite aluminium units

REPRO The HOUSE
REPRODUCTION HOUSE CO



The REPRODUCTION HOUSE CO
 Kristian Knowles
 28 St Johns Road
 Epping
 Essex
 CM165DP
 Mob:07504 295 439

Drawing
As Built Elevations

Project
**New Dwelling House
 "Lovefields"
 Stables To The Rear Of
 2 St. Stephans Cottages,
 Chalk Lane, Harlow,
 Essex, CM17 0PQ.**

REPRO The HOUSE
REPRODUCTION HOUSE CO

Scale	1:100 (A1)
Date	25-04-2023
Dwg no.	A.B.1

E.F.D.C
ESSEX COUNTY COUNCIL
LABC
Local Authority Building Control

SCALE 1:100 (A1) 1:100 (A1) 0 1 2 3 4 5 6 7 8 9 10 11 12 13 14 15 16 17 18 19 20