



LOCATION PLAN



AS APPROVED FRONT & REAR ELEVATIONS

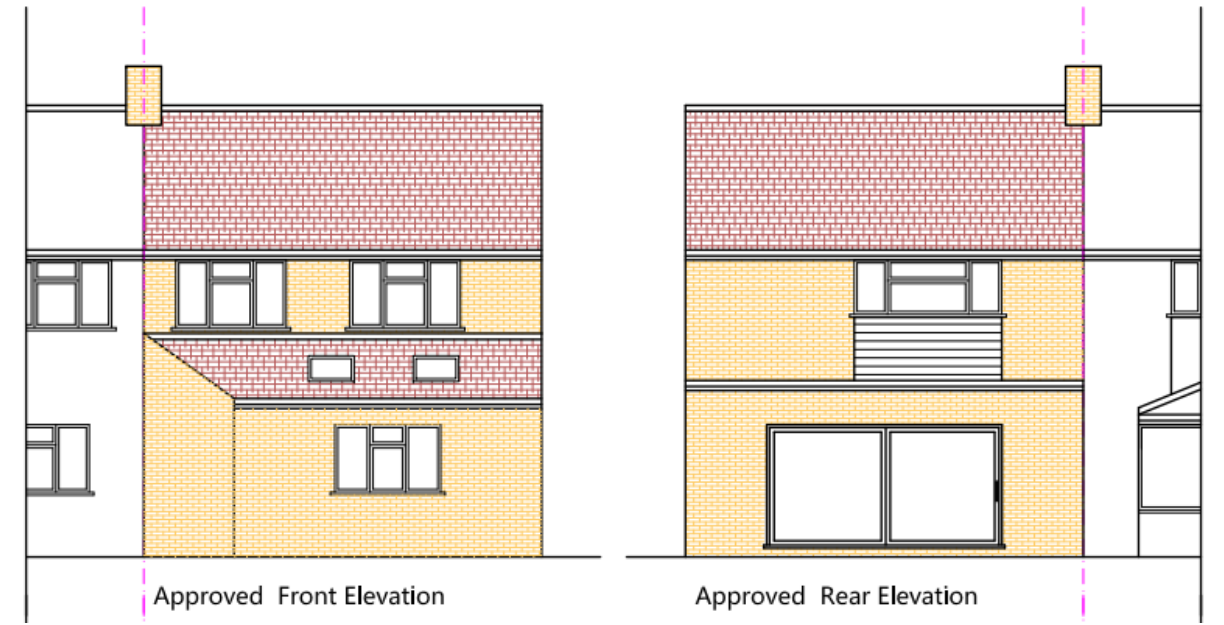


AS BUILT/PROPOSED FRONT & REAR ELEVATIONS

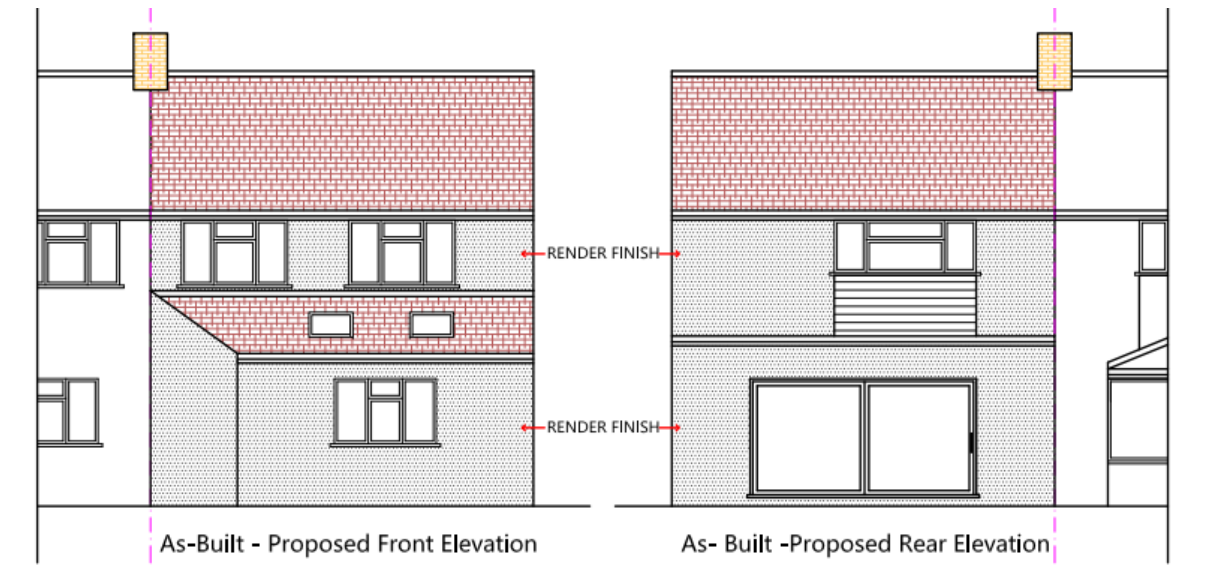

AS APPROVED SIDE ELEVATIONS



Approved Side Elevation - A

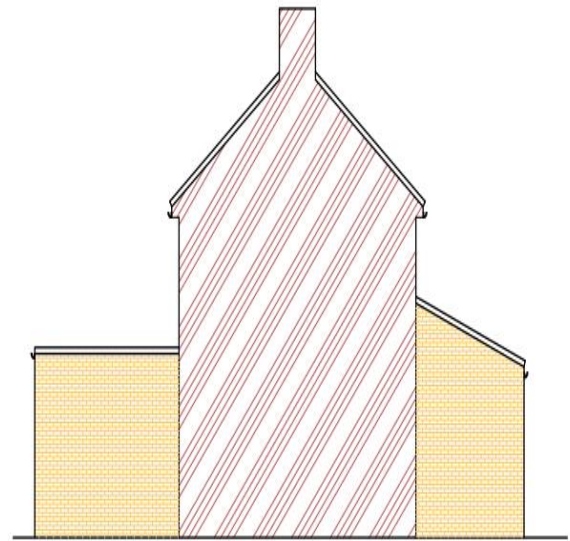


Approved Side Elevation - B

AS BUILT/PROPOSED SIDE ELEVATIONS



As-Built-Proposed Side Elevation - A

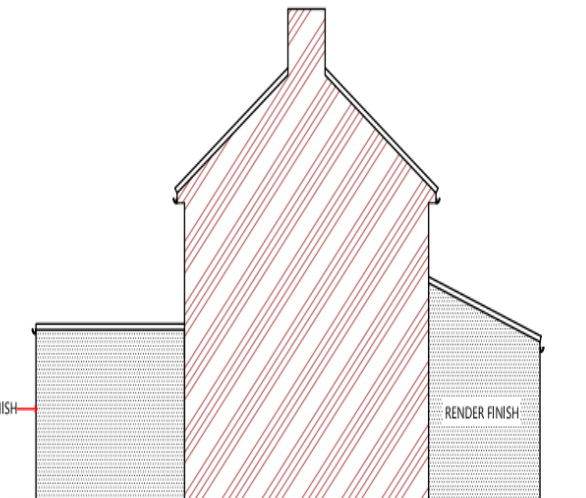

As-Built-Proposed Side Elevation - B